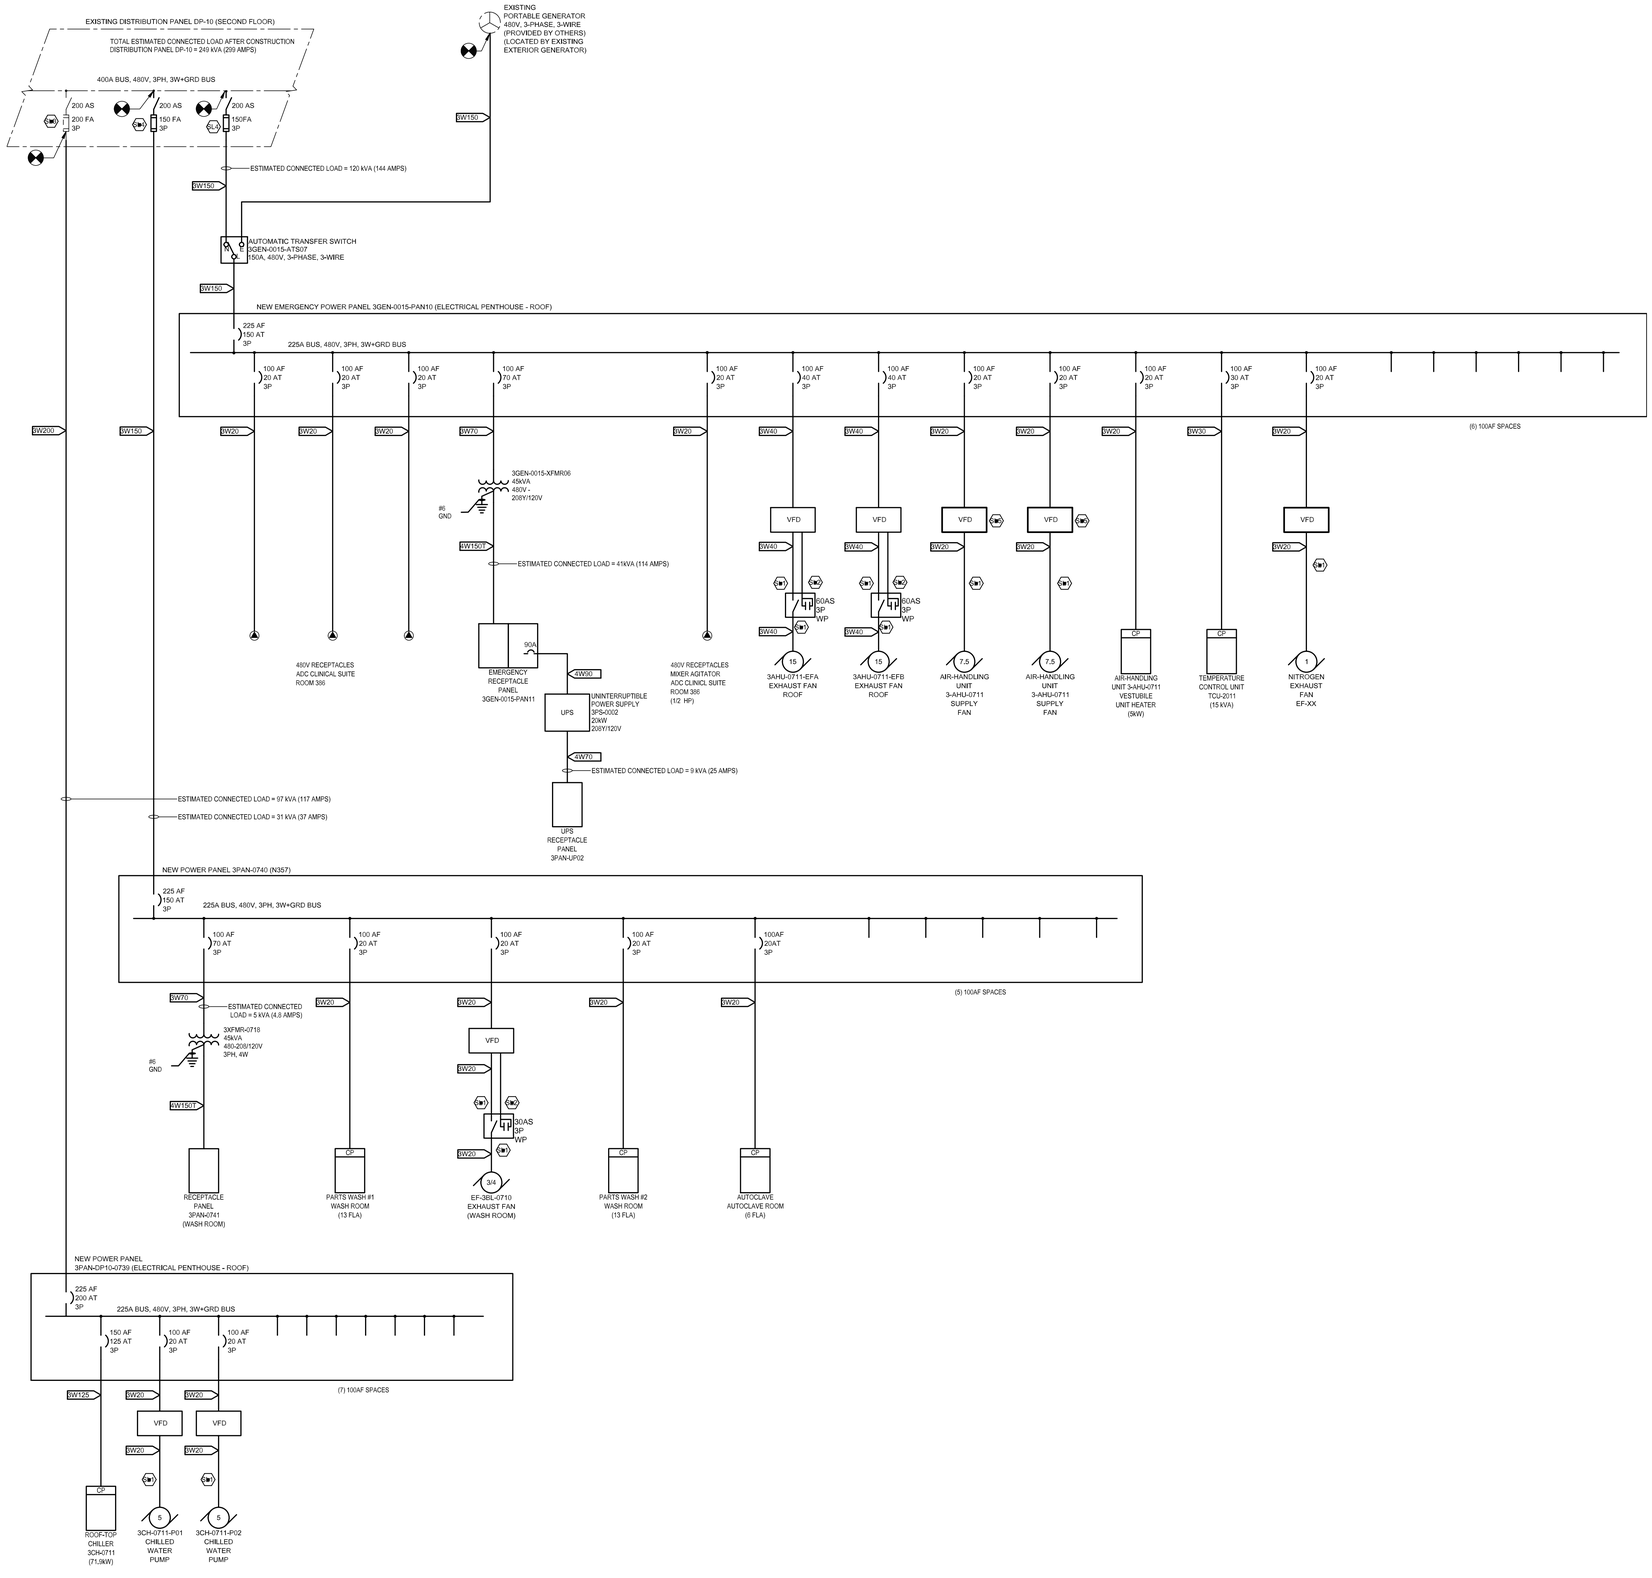


GENERAL NOTES:

1. FOR A LIST OF SYMBOLS AND ABBREVIATIONS, SEE DRAWING 18-2038-E-00.
2. FOR EXACT LOCATION OF MECHANICAL EQUIPMENT, REFER TO APPROPRIATE TRADE DRAWINGS.

(#) SHEET NOTES

SL1 PROVIDE BELDEN SYMMETRICAL DESIGN VFD CABLE IN CONDUIT FROM EACH VFD TO MOTOR SERVED.

SL2 PROVIDE ENCLOSED SAFETY SWITCH WITH ELECTRICAL INTERLOCK KIT. PROVIDE 2#18 AWG WIRE FROM INTERLOCK CONTACT TO VFD SAFTIES CIRCUIT.

SL3 UTILIZE EXISTING "SPARE" 200A/3P FUSED DISCONNECT SWITCH IN DISTRIBUTION PANEL DP-10 FOR FEED TO NEW EQUIPMENT SHOWN. PROVIDE NEW (3) 200A FUSES IN EXISTING FUSED DISCONNECT SWITCH.

SL4 REWORK EXISTING FUSED DISCONNECT SWITCHES IN EXISTING DISTRIBUTION PANEL DP-10 AS REQUIRED TO ACCOMODATE NEW SWITCHES INDICATED.

SL5 VFD SHALL BE PROVIDED BY AHU VENDOR.

FEEDER SCHEDULE

FEEDER NUMBER	ALL FEEDER SIZES MAY NOT APPEAR ON THESE DWGS.		
(#)	NO. OF CONDUITS	SIZE OF CONDUITS	NO. AND SIZE OF CONDUCTORS IN EACH CONDUIT
3W20	1	3/4"	3#12 AWG & 1#12 GND
4W20	1	3/4"	4#12 AWG & 1#12 GND
2W30	1	3/4"	2#10 AWG & 1#10 GND
3W30	1	3/4"	3#10 AWG & 1#10 GND
4W30	1	3/4"	4#10 AWG & 1#10 GND
2W40	1	1"	2#8 AWG & 1#10 GND
3W40	1	1"	3#8 AWG & 1#10 GND
4W40	1	1"	4#8 AWG & 1#10 GND
3W50	1	1"	3#6 AWG & 1#10 GND
4W50	1	1"	4#6 AWG & 1#10 GND
3W70	1	1 1/2"	3#4 AWG & 1#8 GND
4W70	1	1 1/2"	4#4 AWG & 1#8 GND
3W90	1	1 1/2"	3#2 AWG & 1#8 GND
4W90	1	1 1/2"	4#2 AWG & 1#8 GND
3W110	1	2"	3#1 AWG & 1#6 GND
4W110	1	2"	4#1 AWG & 1#6 GND
3W150	1	2"	3#1/0 AWG & 1#6 GND
4W150	1	2"	4#1/0 AWG & 1#6 GND
3W175	1	2"	3#2/0 AWG & 1#6 GND
4W175	1	2"	4#2/0 AWG & 1#6 GND
3W200	1	2"	3#3/0 AWG & 1#6 GND
4W200	1	2"	4#3/0 AWG & 1#6 GND

TRANSFORMER FEEDER SCHEDULE

FEEDER NUMBER	ALL FEEDER SIZES MAY NOT APPEAR ON THESE DWGS.		
(#)	NO. OF CONDUITS	SIZE OF CONDUITS	NO. AND SIZE OF CONDUCTORS IN EACH CONDUIT
4W150T	1	2"	3#1/0 + 1#1/0 NEUTRAL + 1#6 GROUND

1 18-2038-E-50 SINGLE LINE DIAGRAM
SCALE: NONE

THESE RECORD DOCUMENTS HAVE BEEN PREPARED BASED ON REDLINE INFORMATION PROVIDED BY OTHERS, AND IN ALL RESPECTS, IPS AS ARCHITECT/ENGINEER, RELIED UPON THE INFORMATION CONTAINED IN THE REDLINE DOCUMENTS RECEIVED. IT IS NOT IN THE SCOPE OF IPS, AS THE ARCHITECT/ENGINEER, TO INVESTIGATE, CERTIFY, VALIDATE OR OTHERWISE PERFORM INDEPENDENT TESTS, SURVEYS OR ANALYSES TO VERIFY THE ACCURACY AND/OR COMPLETENESS OF THIS INFORMATION, AND THEREFORE, SUCH INFORMATION WAS NOT VERIFIED, IPS, AS ARCHITECT/ENGINEER, IS NOT RESPONSIBLE FOR ANY ERRORS OR OMISSIONS THAT MAY BE INCORPORATED AS A RESULT OF ERRONEOUS INFORMATION PROVIDED BY OTHERS.

SEAL

THIS IS NOT A SEALED DOCUMENT

RECORD DRAWING

REVISION	DESCRIPTION	BY	DATE
1	RECORD DRAWING	CJD	11/16/21
0	CONSTRUCTION ISSUE	CJD	07/02/20
B	90% OWNER REVIEW ISSUE	CJD	06/19/20
A	DD SUBMITTAL PACKAGE	CJD	05/08/20

MISSOURI ENGINEERING CORPORATE CERTIFICATE OF AUTHORITY LICENSE NUMBER 2078039199
IPS Professional Engineers and Architects, LLC.
13200 METCALF AVE. SUITE 400
OVERLAND PARK, KANSAS 66213

MISSOURI ARCHITECTURAL CORPORATE CERTIFICATE OF AUTHORITY LICENSE NUMBER A-2077032053
McGrath & Associates, Inc.
1920 S. KINGSHIGHWAY BLVD.
SAINT LOUIS, MISSOURI 63110

A bulisness of MERCK KGaA, Darmstadt, Germany

PROJECT LOCATION:
MILLIPORE SIGMA
3300 SOUTH 2ND STREET
SAINT LOUIS, MISSOURI 63118

TITLE:
ADC CLINICAL EXPANSION
SINGLE LINE DIAGRAM

SITE: CHEROKEE	BLDG: N		FLOOR: 3
SCALE: NONE	DRAWN: PAL	DATE: 7/2/20	DWG NO: 18-2038-E-50
	APPROVED: CJD	DATE: 7/2/20	