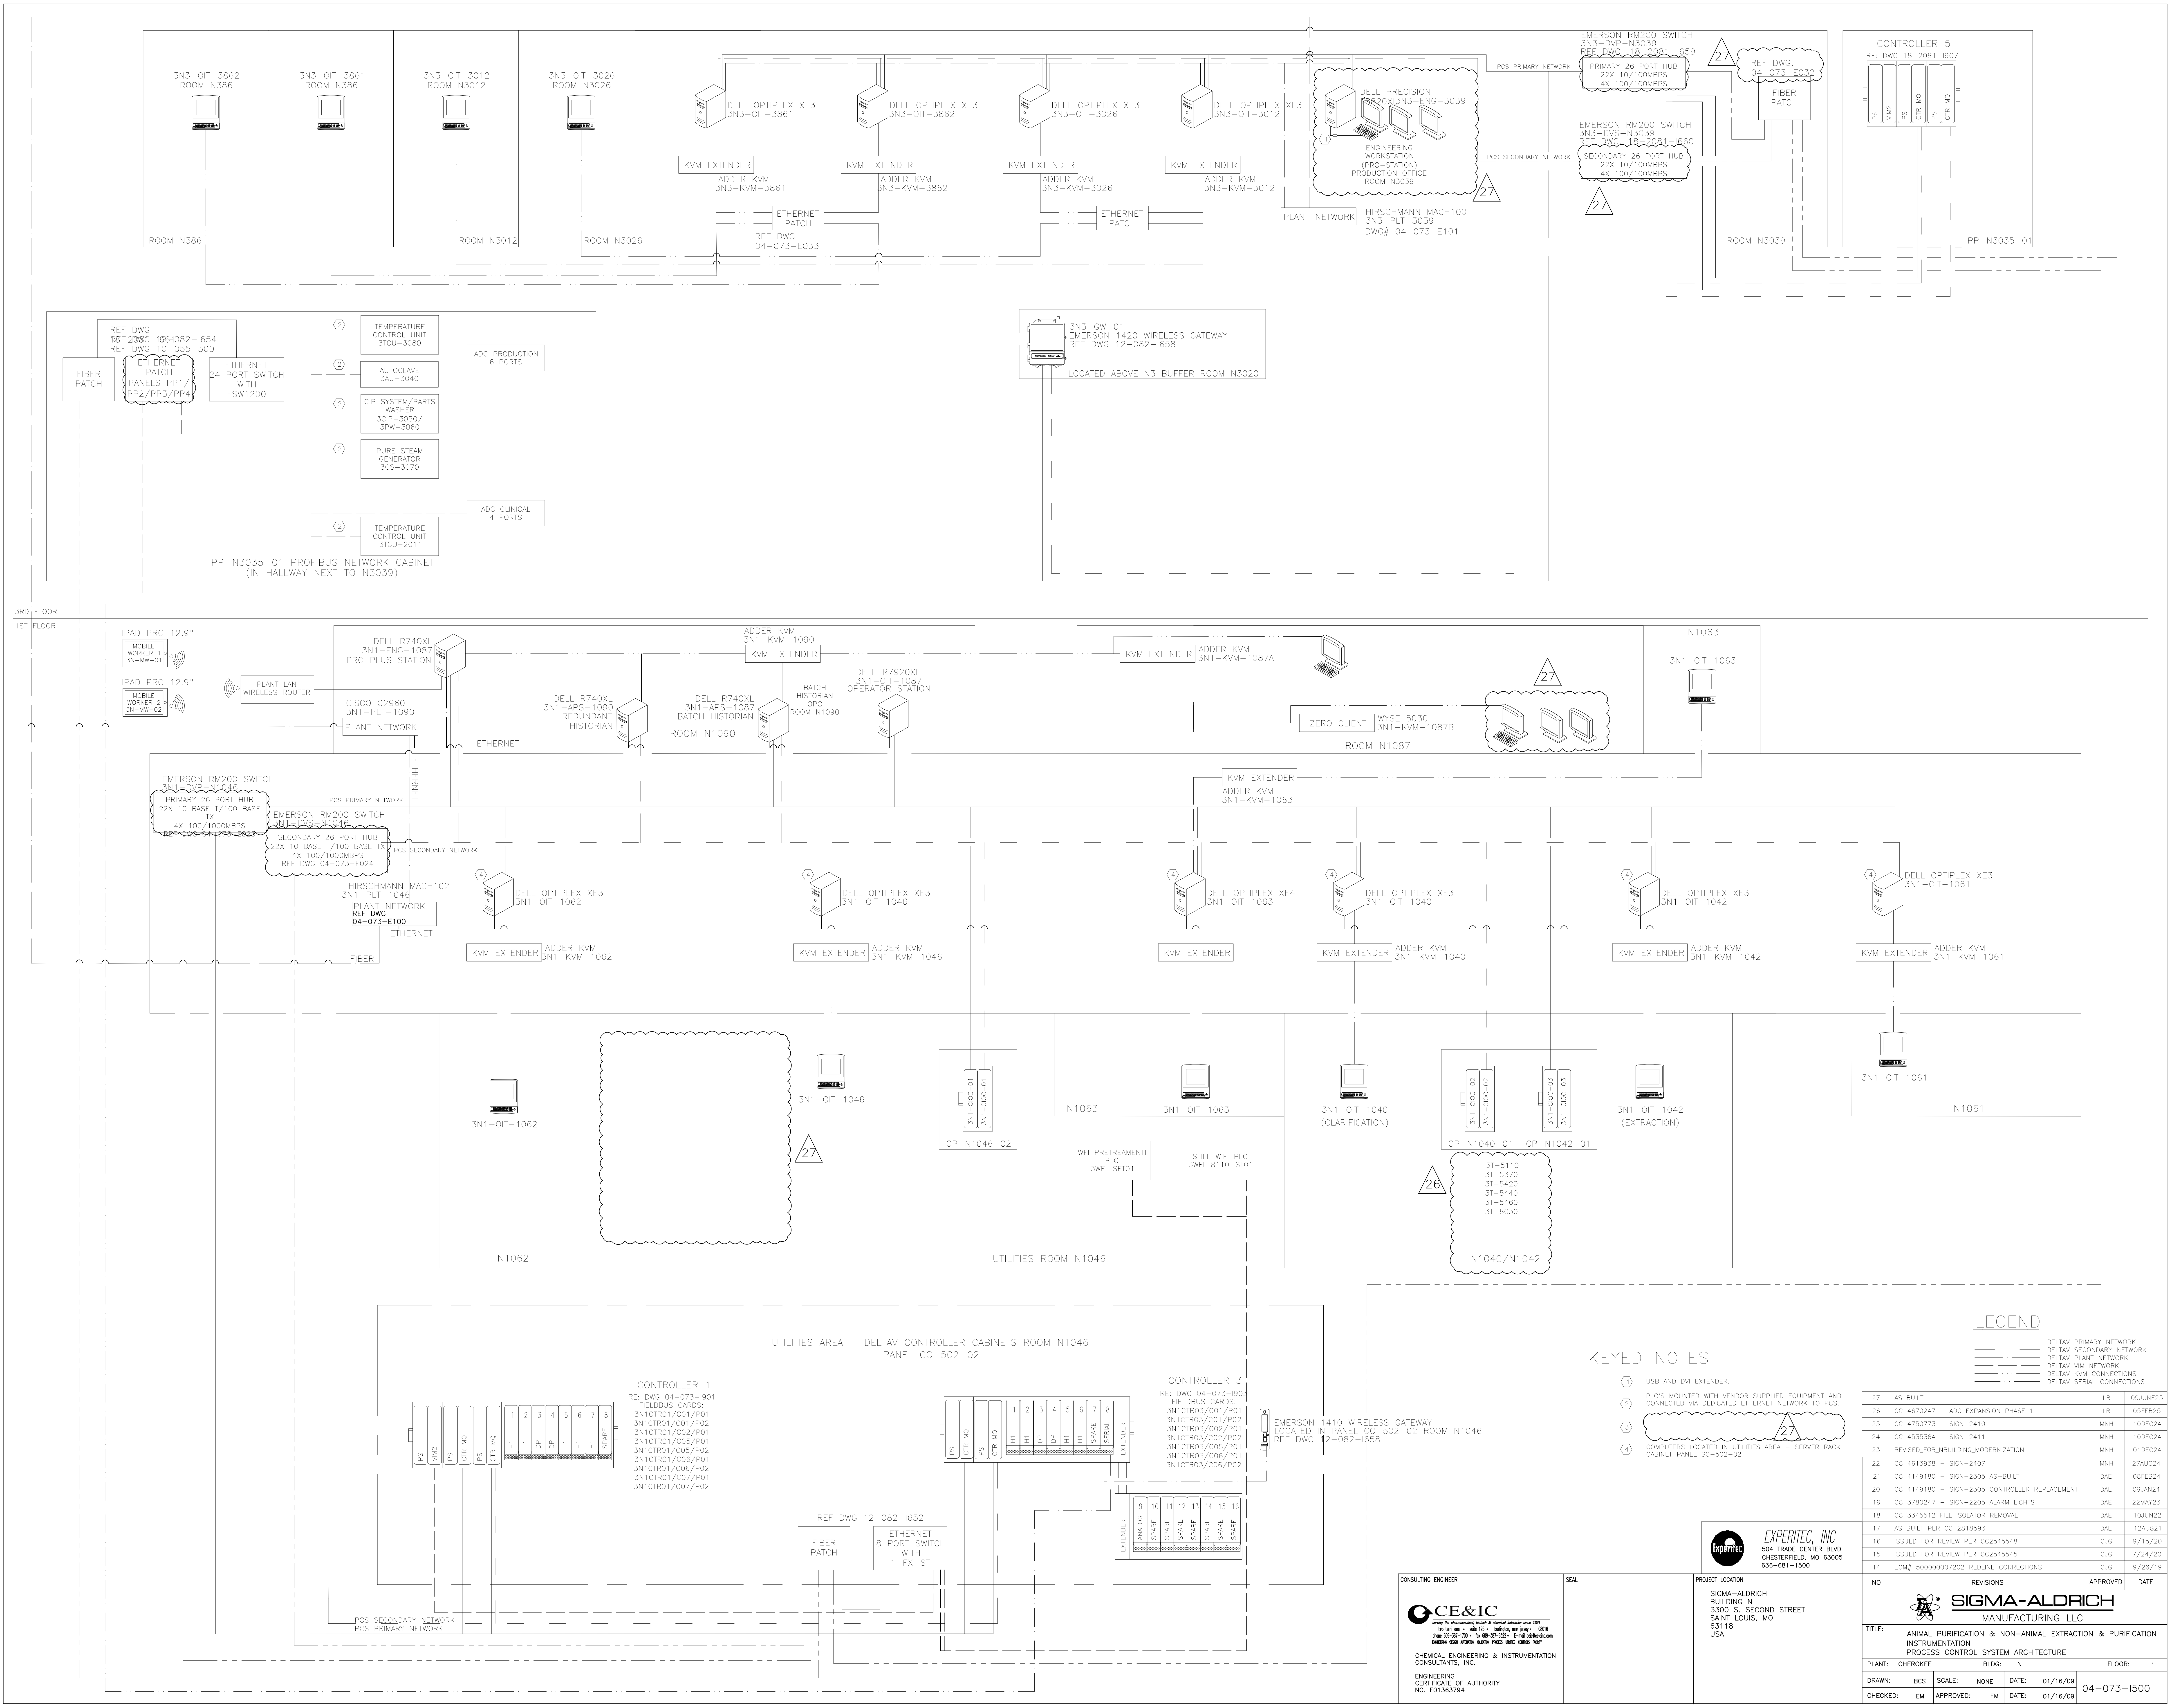

3N3-OIT-3862 ROOM N386
3N3-OIT-3861 ROOM N386
3N3-OIT-3012 ROOM N3012
3N3-OIT-3026 ROOM N3026
ROOM N386
ROOM N3012
ROOM N3026
DELL OPTIPLEX XE3 3N3-OIT-3861
DELL OPTIPLEX XE3 3N3-OIT-3862
DELL OPTIPLEX XE3 3N3-OIT-3026
DELL OPTIPLEX XE3 3N3-OIT-3012
KVM EXTENDER
ADDER KVM 3N3-KVM-3861
ADDER KVM 3N3-KVM-3862
ADDER KVM 3N3-KVM-3026
ADDER KVM 3N3-KVM-3012
ETHERNET PATCH
REF DWG 04-073-E033
DELL PRECISION T5820XL 3N3-ENG-3039
ENGINEERING WORKSTATION (PRO-STATION) PRODUCTION OFFICE ROOM N3039
PLANT NETWORK
HIRSCHMANN MACH100 3N3-PLT-3039 DWG# 04-073-E101
PCS PRIMARY NETWORK
PCS SECONDARY NETWORK
EMERSON RM200 SWITCH 3N3-DVP-N3039 REF DWG. 18-2081-I659
PRIMARY 26 PORT HUB 22X 10/100MBPS 4X 100/100MBPS
EMERSON RM200 SWITCH 3N3-DVS-N3039 REF DWG. 18-2081-I660
SECONDARY 26 PORT HUB 22X 10/100MBPS 4X 100/100MBPS
REF DWG. 04-073-E032
FIBER PATCH
ROOM N3039
CONTROLLER 5
RE: DWG 18-2081-I907
PS
VIM2
PS
CTR MQ
PS
CTR MQ
PP-N3035-01
27
REF DWG 18-2081-I26 12-082-I654
REF DWG 10-055-500
FIBER PATCH
ETHERNET PATCH PANELS PP1/ PP2/PP3/PP4
ETHERNET 24 PORT SWITCH WITH ESW1200
2
TEMPERATURE CONTROL UNIT 3TCU-3080
AUTOCLAVE 3AU-3040
CIP SYSTEM/PARTS WASHER 3CIP-3050/ 3PW-3060
PURE STEAM GENERATOR 3CS-3070
TEMPERATURE CONTROL UNIT 3TCU-2011
ADC PRODUCTION 6 PORTS
ADC CLINICAL 4 PORTS
PP-N3035-01 PROFIBUS NETWORK CABINET (IN HALLWAY NEXT TO N3039)
3N3-GW-01 EMERSON 1420 WIRELESS GATEWAY REF DWG 12-082-I658
LOCATED ABOVE N3 BUFFER ROOM N3020
3RD FLOOR
1ST FLOOR
FIBER
IPAD PRO 12.9"
MOBILE WORKER 1 3N-MW-01
IPAD PRO 12.9"
MOBILE WORKER 2 3N-MW-02
PLANT LAN WIRELESS ROUTER
DELL R740XL 3N1-ENG-1087 PRO PLUS STATION
CISCO C2960 3N1-PLT-1090
PLANT NETWORK
ETHERNET
ADDER KVM 3N1-KVM-1090
KVM EXTENDER
DELL R740XL 3N1-APS-1090 REDUNDANT HISTORIAN
DELL R740XL 3N1-APS-1087 BATCH HISTORIAN
BATCH HISTORIAN OPC ROOM N1090
ROOM N1090
DELL R7920XL 3N1-OIT-1087 OPERATOR STATION
KVM EXTENDER
ADDER KVM 3N1-KVM-1087A
ZERO CLIENT
WYSE 5030 3N1-KVM-1087B
ROOM N1087
N1063
3N1-OIT-1063
EMERSON RM200 SWITCH 3N1-DVP-N1046
PRIMARY 26 PORT HUB 22X 10 BASE T/100 BASE TX 4X 100/1000MBPS REF DWG 04-073-E023
EMERSON RM200 SWITCH 3N1-DVS-N1046
SECONDARY 26 PORT HUB 22X 10 BASE T/100 BASE TX 4X 100/1000MBPS REF DWG 04-073-E024
PCS PRIMARY NETWORK
PCS SECONDARY NETWORK
ETHERNET
HIRSCHMANN MACH102 3N1-PLT-1046
PLANT NETWORK REF DWG 04-073-E100
ETHERNET
FIBER
KVM EXTENDER
ADDER KVM 3N1-KVM-1063
4
DELL OPTIPLEX XE3 3N1-OIT-1062
DELL OPTIPLEX XE3 3N1-OIT-1046
DELL OPTIPLEX XE4 3N1-OIT-1063
DELL OPTIPLEX XE3 3N1-OIT-1040
DELL OPTIPLEX XE3 3N1-OIT-1042
DELL OPTIPLEX XE3 3N1-OIT-1061
KVM EXTENDER
ADDER KVM 3N1-KVM-1062
ADDER KVM 3N1-KVM-1046
ADDER KVM 3N1-KVM-1040
ADDER KVM 3N1-KVM-1042
ADDER KVM 3N1-KVM-1061
3N1-OIT-1062
N1062
3N1-OIT-1046
3N1-CIOC-01
3N1-CIOC-01
CP-N1046-02
N1063
3N1-OIT-1063
WFI PRETREAMENTI PLC 3WFI-SFT01
STILL WIFI PLC 3WFI-8110-ST01
UTILITIES ROOM N1046
3N1-OIT-1040 (CLARIFICATION)
3N1-CIOC-02
3N1-CIOC-02
3N1-CIOC-03
3N1-CIOC-03
CP-N1040-01
CP-N1042-01
3T-5110
3T-5370
3T-5420
3T-5440
3T-5460
3T-8030
N1040/N1042
26
3N1-OIT-1042 (EXTRACTION)
3N1-OIT-1061
N1061
UTILITIES AREA – DELTAV CONTROLLER CABINETS ROOM N1046 PANEL CC-502-02
CONTROLLER 1
RE: DWG 04-073-I901
FIELDBUS CARDS:
3N1CTR01/C01/P01
3N1CTR01/C01/P02
3N1CTR01/C02/P01
3N1CTR01/C05/P01
3N1CTR01/C05/P02
3N1CTR01/C06/P01
3N1CTR01/C06/P02
3N1CTR01/C07/P01
3N1CTR01/C07/P02
PS
VIM2
PS
CTR MQ
PS
CTR MQ
1 2 3 4 5 6 7 8
H1 H1 DP DP H1 H1 H1 SPARE
CONTROLLER 3
RE: DWG 04-073-I903
FIELDBUS CARDS:
3N1CTR03/C01/P01
3N1CTR03/C01/P02
3N1CTR03/C02/P01
3N1CTR03/C02/P02
3N1CTR03/C05/P01
3N1CTR03/C06/P01
3N1CTR03/C06/P02
PS
CTR MQ
PS
CTR MQ
1 2 3 4 5 6 7 8
H1 H1 DP DP H1 H1 SPARE SERIAL
EXTENDER
9 10 11 12 13 14 15 16
ANALOG SPARE SPARE SPARE SPARE SPARE SPARE SPARE
EXTENDER
EMERSON 1410 WIRELESS GATEWAY LOCATED IN PANEL CC-502-02 ROOM N1046 REF DWG 12-082-I658
REF DWG 12-082-I652
FIBER PATCH
ETHERNET 8 PORT SWITCH WITH 1-FX-ST
PCS SECONDARY NETWORK
PCS PRIMARY NETWORK

KEYED NOTES

⟨1⟩ USB AND DVI EXTENDER.

⟨2⟩ PLC'S MOUNTED WITH VENDOR SUPPLIED EQUIPMENT AND CONNECTED VIA DEDICATED ETHERNET NETWORK TO PCS.

⟨3⟩ 27

⟨4⟩ COMPUTERS LOCATED IN UTILITIES AREA – SERVER RACK CABINET PANEL SC-502-02

LEGEND

———————	DELTAV PRIMARY NETWORK
—— ——	DELTAV SECONDARY NETWORK
——— · ———	DELTAV PLANT NETWORK
—— —— ——	DELTAV VIM NETWORK
——— · · · ———	DELTAV KVM CONNECTIONS
——— · · ———	DELTAV SERIAL CONNECTIONS

NO	REVISIONS	APPROVED	DATE
27	AS BUILT	LR	09JUNE25
26	CC 4670247 – ADC EXPANSION PHASE 1	LR	05FEB25
25	CC 4750773 – SIGN-2410	MNH	10DEC24
24	CC 4535364 – SIGN-2411	MNH	10DEC24
23	REVISED_FOR_NBUILDING_MODERNIZATION	MNH	01DEC24
22	CC 4613938 – SIGN-2407	MNH	27AUG24
21	CC 4149180 – SIGN-2305 AS-BUILT	DAE	08FEB24
20	CC 4149180 – SIGN-2305 CONTROLLER REPLACEMENT	DAE	09JAN24
19	CC 3780247 – SIGN-2205 ALARM LIGHTS	DAE	22MAY23
18	CC 3345512 FILL ISOLATOR REMOVAL	DAE	10JUN22
17	AS BUILT PER CC 2818593	DAE	12AUG21
16	ISSUED FOR REVIEW PER CC2545548	CJG	9/15/20
15	ISSUED FOR REVIEW PER CC2545545	CJG	7/24/20
14	ECM# 500000007202 REDLINE CORRECTIONS	CJG	9/26/19

EXPERITEC, INC
504 TRADE CENTER BLVD
CHESTERFIELD, MO 63005
636-681-1500

CONSULTING ENGINEER

CE&IC
serving the pharmaceutical, biotech & chemical industries since 1984
two terri lane • suite 125 • burlington, new jersey • 08016
phone 609-387-1700 • fax 609-387-9322 • E-mail ceic@ceicinc.com
ENGINEERING DESIGN AUTOMATION VALIDATION PROCESS UTILITIES CONTROLS FACILITY

CHEMICAL ENGINEERING & INSTRUMENTATION CONSULTANTS, INC.

ENGINEERING
CERTIFICATE OF AUTHORITY
NO. F01363794

SEAL

PROJECT LOCATION

SIGMA-ALDRICH
BUILDING N
3300 S. SECOND STREET
SAINT LOUIS, MO
63118
USA

SIGMA-ALDRICH
MANUFACTURING LLC

TITLE: ANIMAL PURIFICATION & NON-ANIMAL EXTRACTION & PURIFICATION
INSTRUMENTATION
PROCESS CONTROL SYSTEM ARCHITECTURE

PLANT:	CHEROKEE	BLDG:	N			FLOOR:	1
DRAWN:	BCS	SCALE:	NONE	DATE:	01/16/09	04-073-I500	
CHECKED:	EM	APPROVED:	EM	DATE:	01/16/09		