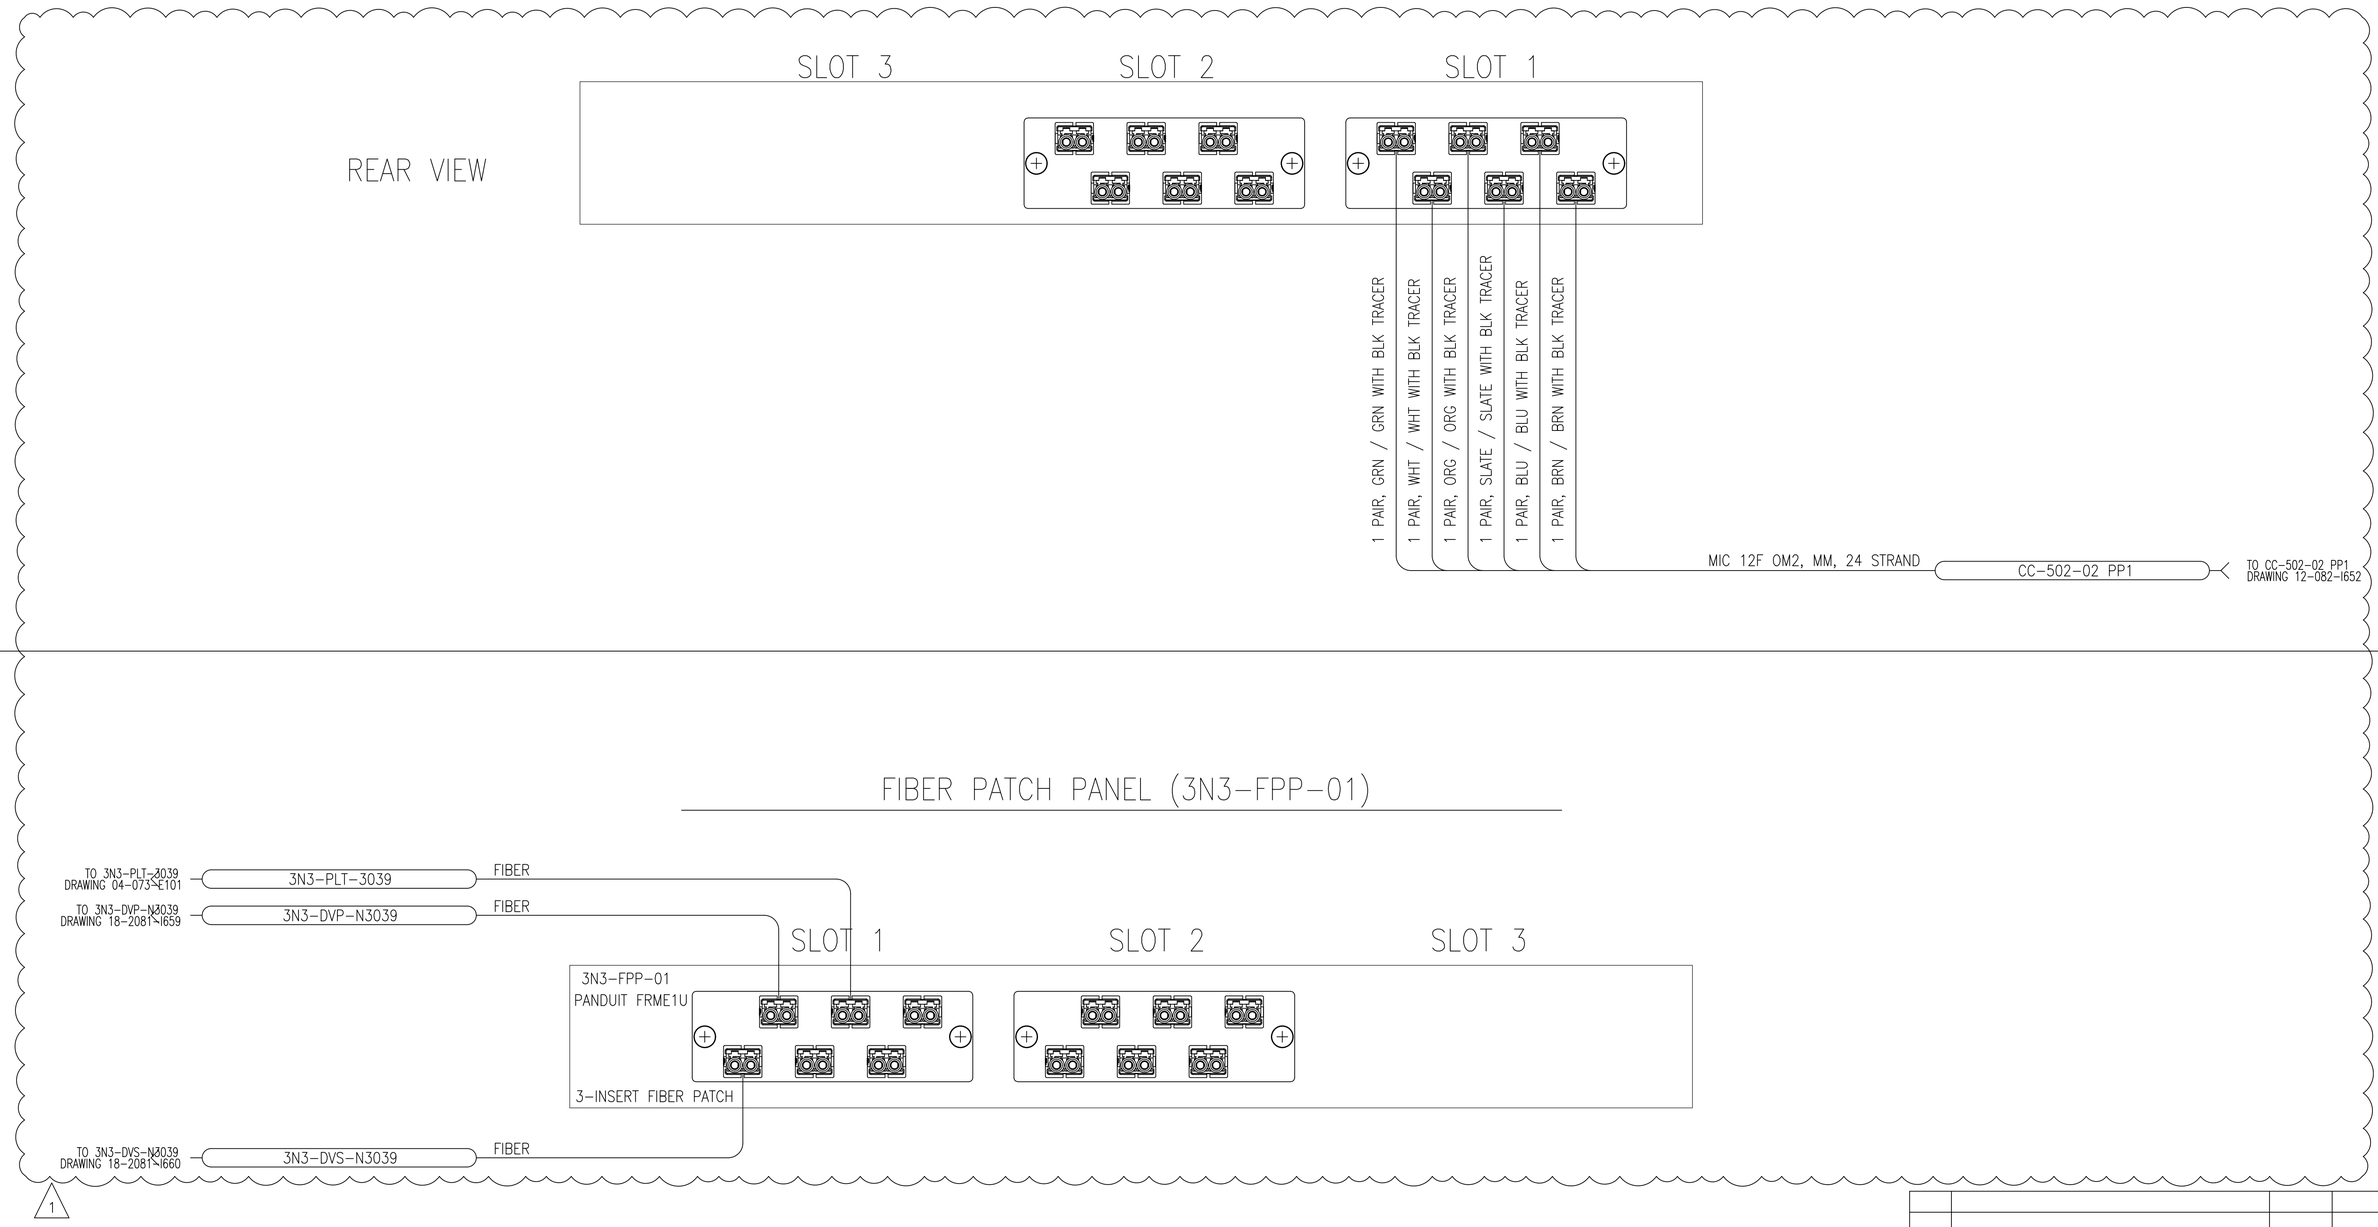


NO	REVISIONS	APPROVED	DATE
1	AS BUILT PER SIGP-2001 CC2545548	DAE	08AUG22
0	ISSUED FOR REVIEW PER CC2545548	CJG	9/11/2020

MilliporeSigma
A business of Merck KGaA, Darmstadt, Germany

TITLE: N3039 DELTAV NETWORK PANEL
3N3-FPP-PP1
FIBER PATCH PANEL

SITE: CHEROKEE BLDG: N1 FLOOR: 1ST

SCALE:	DRAWN:	DATE: 9/11/2020	DWG NO:
NTS	APPROVED: CJG	DATE:	04-073-E032

EXPERITEC, INC
504 TRADE CENTER BLVD
CHESTERFIELD, MO 63005
636-681-1500