


REAR VIEW

PLANT LAN SWITCH (3N3-PLT-N3039)

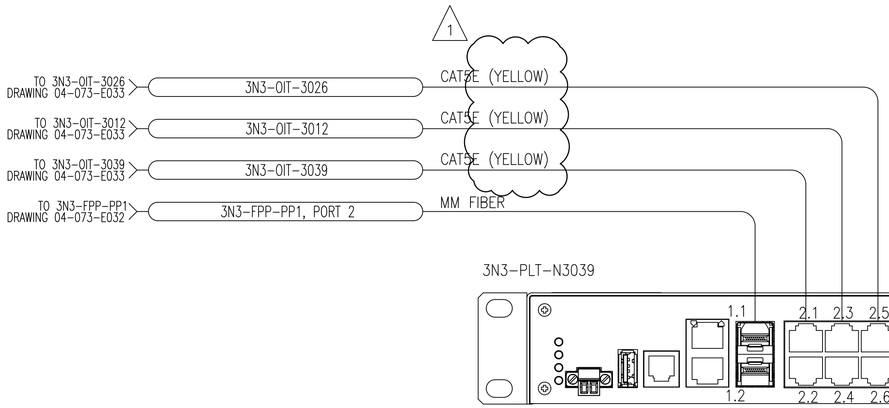

NO	REVISIONS	APPROVED	DATE
1	AS BUILT PER SIGP-2001 CC2545548	DAE	08AUG22
0	ISSUED FOR REVIEW PER CC2545548	CJG	9/11/2020

MilliporeSigma
A business of Merck KGaA, Darmstadt, Germany

TITLE: N3 PP-N3039-01
PLANT LAN SWITCH
OFFICE N3039

SITE: CHEROKEE BLDG: N1 FLOOR: 1ST

SCALE:	DRAWN:	DATE: 7/24/20	DWG NO:
NTS	APPROVED: CJG	DATE:	04-073-E101

EXPERITEC, INC
504 TRADE CENTER BLVD
CHESTERFIELD, MO 63005
636-681-1500