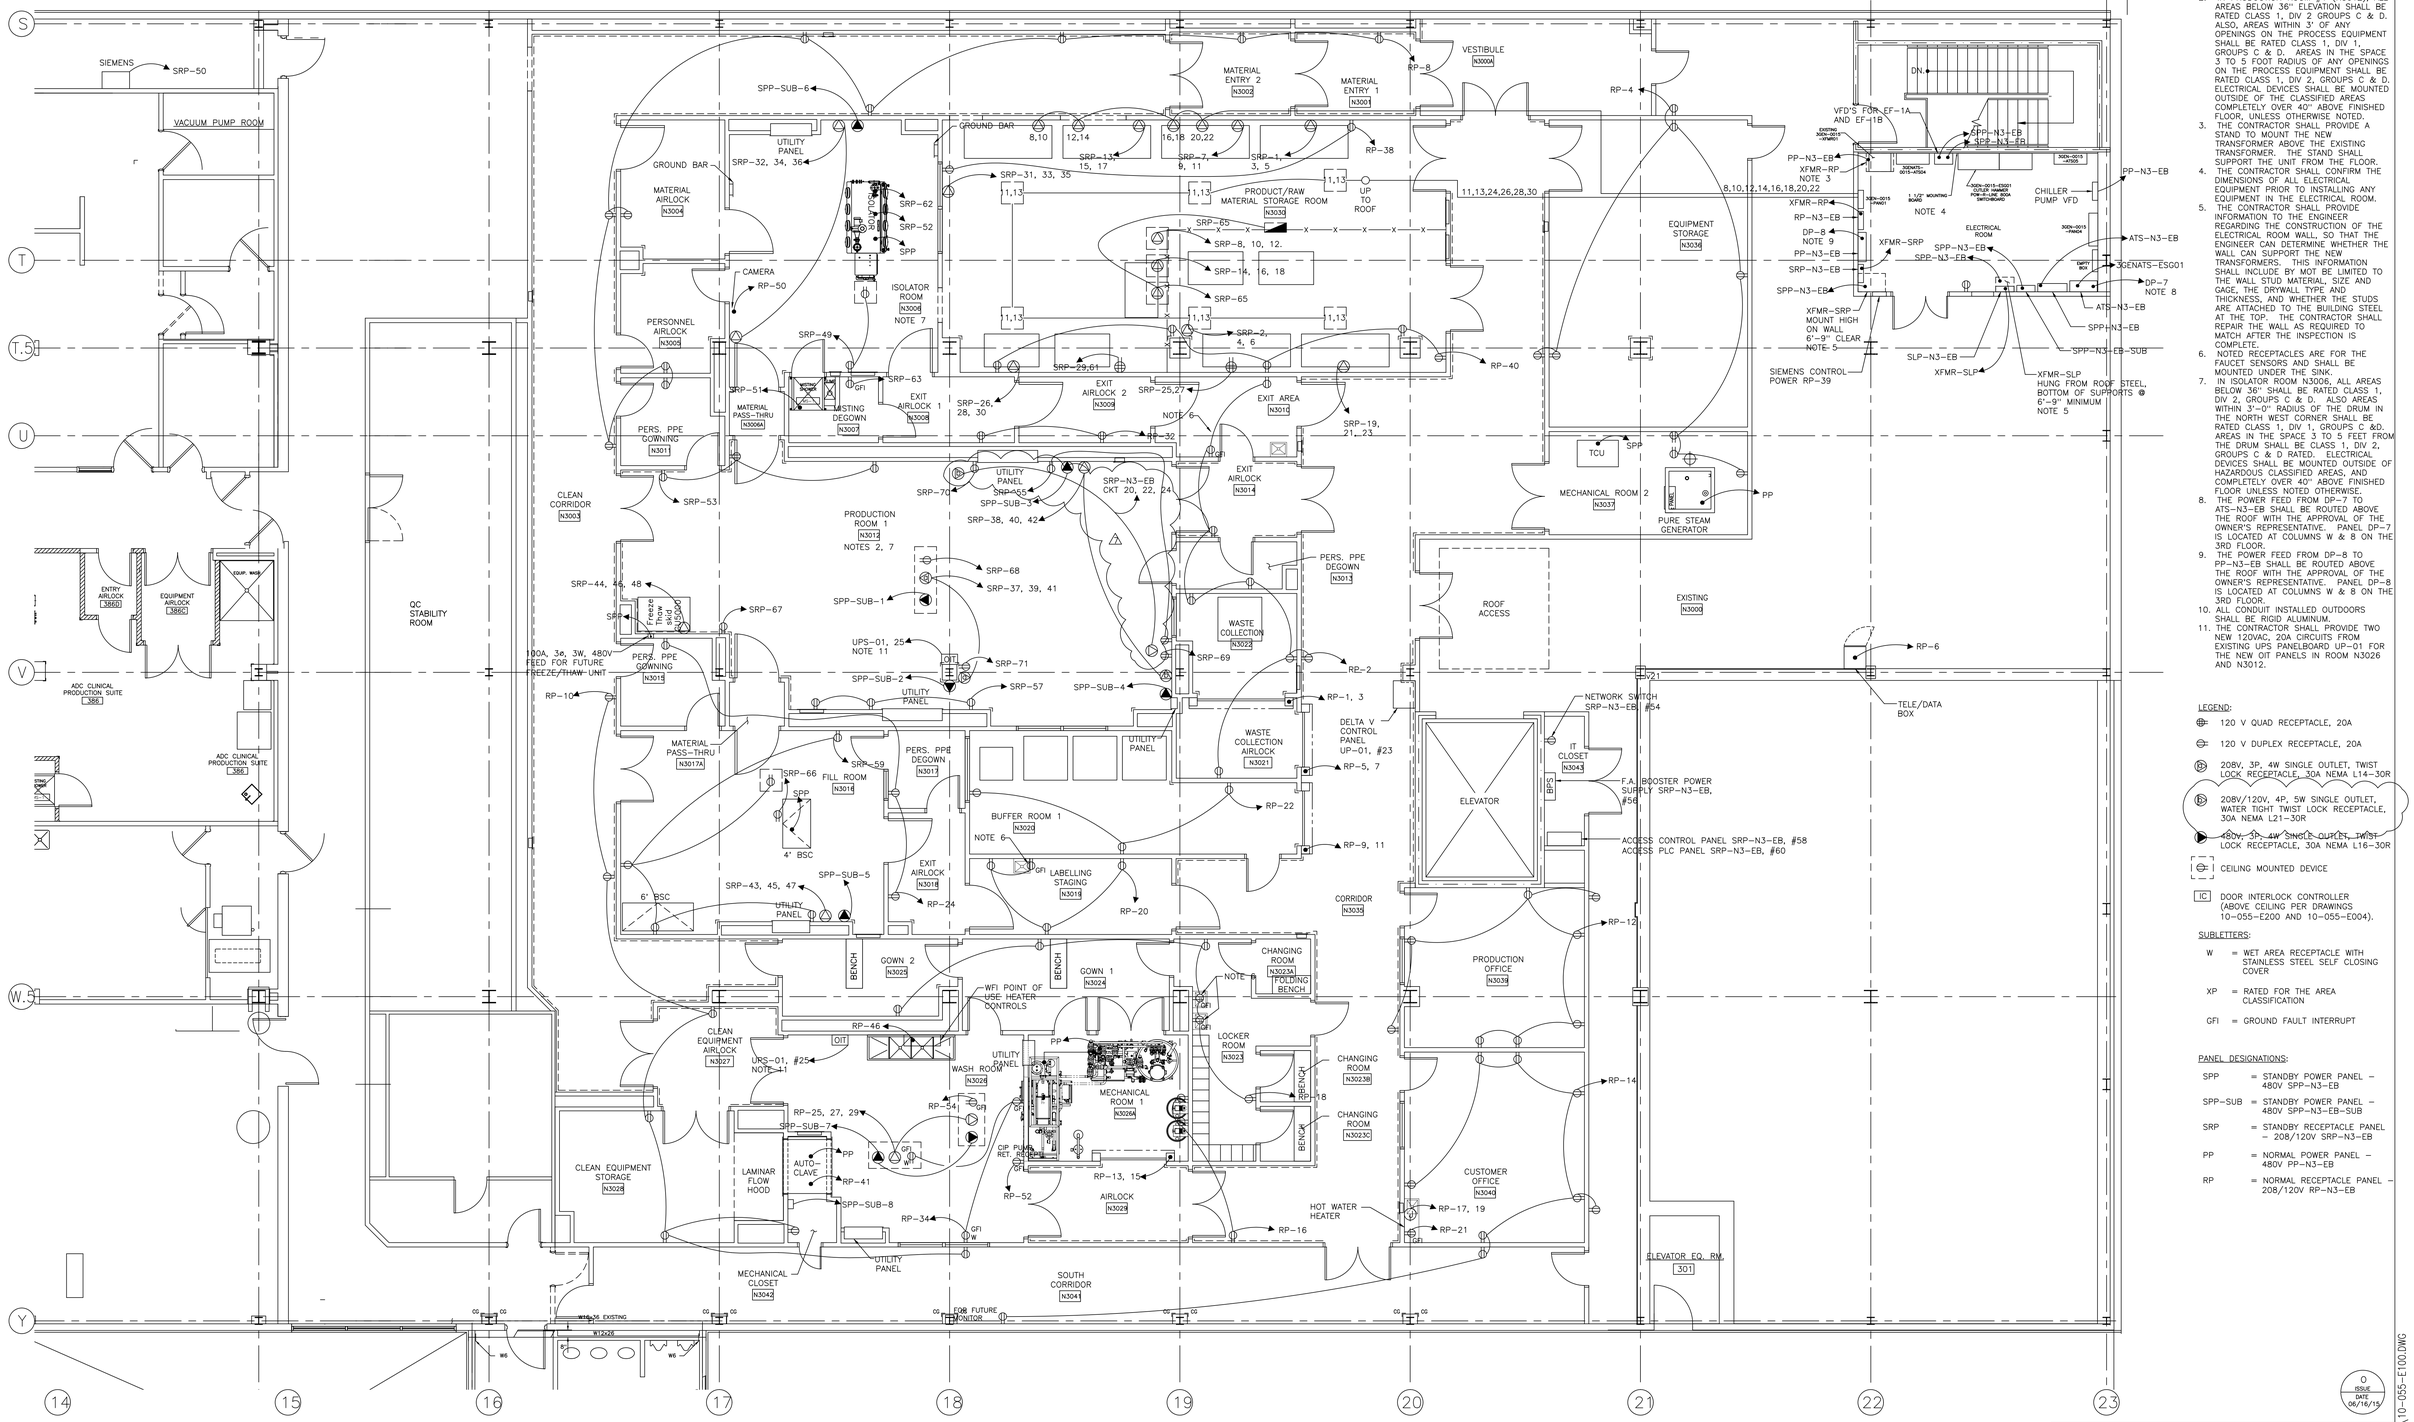


PLAN VIEW
SCALE: 3/16"=1'-0"

NOTES:
1. ALL NOTES AND SYMBOLS ON DRAWING 10-055-E000 APPLY TO THIS DRAWING.
2. IN PRODUCTION ROOM #1 (N3012), ALL AREAS BELOW 36" ELEVATION SHALL BE RATED CLASS 1, DIV 2 GROUPS C & D. ALSO, AREAS WITHIN 3' OF ANY OPENINGS ON THE PROCESS EQUIPMENT SHALL BE RATED CLASS 1, DIV 1, GROUPS C & D. AREAS IN THE SPACE 3 TO 5 FOOT RADIUS OF ANY OPENINGS ON THE PROCESS EQUIPMENT SHALL BE RATED CLASS 1, DIV 2, GROUPS C & D. ELECTRICAL DEVICES SHALL BE MOUNTED OUTSIDE OF THE CLASSIFIED AREAS COMPLETELY OVER 40" ABOVE FINISHED FLOOR, UNLESS OTHERWISE NOTED.
3. THE CONTRACTOR SHALL PROVIDE A STAND TO MOUNT THE NEW TRANSFORMER ABOVE THE EXISTING TRANSFORMER. THE STAND SHALL SUPPORT THE UNIT FROM THE FLOOR.
4. THE CONTRACTOR SHALL CONFIRM THE DIMENSIONS OF ALL ELECTRICAL EQUIPMENT PRIOR TO INSTALLING ANY EQUIPMENT IN THE ELECTRICAL ROOM.
5. THE CONTRACTOR SHALL PROVIDE INFORMATION TO THE ENGINEER REGARDING THE CONSTRUCTION OF THE ELECTRICAL ROOM WALL, SO THAT THE ENGINEER CAN DETERMINE WHETHER THE WALL CAN SUPPORT THE NEW TRANSFORMERS. THIS INFORMATION SHALL INCLUDE BY MOT BE LIMITED TO THE WALL STUD MATERIAL, SIZE AND GAGE, THE DRYWALL TYPE AND THICKNESS, AND WHETHER THE STUDS ARE ATTACHED TO THE BUILDING STEEL AT THE TOP. THE CONTRACTOR SHALL REPAIR THE WALL AS REQUIRED TO MATCH AFTER THE INSPECTION IS COMPLETE.
6. NOTED RECEPTACLES ARE FOR THE FAUCET SENSORS AND SHALL BE MOUNTED UNDER THE SINK.
7. IN ISOLATOR ROOM N3006, ALL AREAS BELOW 36" SHALL BE RATED CLASS 1, DIV 2, GROUPS C & D. ALSO AREAS WITHIN 3'-0" RADIUS OF THE DRUM IN THE NORTH WEST CORNER SHALL BE RATED CLASS 1, DIV 1, GROUPS C &D. AREAS IN THE SPACE 3 TO 5 FEET FROM THE DRUM SHALL BE CLASS 1, DIV 2, GROUPS C & D RATED. ELECTRICAL DEVICES SHALL BE MOUNTED OUTSIDE OF HAZARDOUS CLASSIFIED AREAS, AND COMPLETELY OVER 40" ABOVE FINISHED FLOOR UNLESS NOTED OTHERWISE.
8. THE POWER FEED FROM DP-7 TO ATS-N3-EB SHALL BE ROUTED ABOVE THE ROOF WITH THE APPROVAL OF THE OWNER'S REPRESENTATIVE. PANEL DP-7 IS LOCATED AT COLUMNS W & 8 ON THE 3RD FLOOR.
9. THE POWER FEED FROM DP-8 TO PP-N3-EB SHALL BE ROUTED ABOVE THE ROOF WITH THE APPROVAL OF THE OWNER'S REPRESENTATIVE. PANEL DP-8 IS LOCATED AT COLUMNS W & 8 ON THE 3RD FLOOR.
10. ALL CONDUIT INSTALLED OUTDOORS SHALL BE RIGID ALUMINUM.
11. THE CONTRACTOR SHALL PROVIDE TWO NEW 120VAC, 20A CIRCUITS FROM EXISTING UPS PANELBOARD UP-01 FOR THE NEW OIT PANELS IN ROOM N3026 AND N3012.

LEGEND:

- 120 V QUAD RECEPTACLE, 20A
- 120 V DUPLEX RECEPTACLE, 20A
- 208V, 3P, 4W SINGLE OUTLET, TWIST LOCK RECEPTACLE, 30A NEMA L14-30R
- 208V/120V, 4P, 5W SINGLE OUTLET, WATER TIGHT TWIST LOCK RECEPTACLE, 30A NEMA L21-30R
- 480V, 3P, 4W SINGLE OUTLET, TWIST LOCK RECEPTACLE, 30A NEMA L16-30R
- CEILING MOUNTED DEVICE
- IC DOOR INTERLOCK CONTROLLER (ABOVE CEILING PER DRAWINGS 10-055-E200 AND 10-055-E004).

SUBLETTERS:


- W = WET AREA RECEPTACLE WITH STAINLESS STEEL SELF CLOSING COVER
- XP = RATED FOR THE AREA CLASSIFICATION
- GFI = GROUND FAULT INTERRUPT

PANEL DESIGNATIONS:

- SPP = STANDBY POWER PANEL – 480V SPP-N3-EB
- SPP-SUB = STANDBY POWER PANEL – 480V SPP-N3-EB-SUB
- SRP = STANDBY RECEPTACLE PANEL – 208/120V SRP-N3-EB
- PP = NORMAL POWER PANEL – 480V PP-N3-EB
- RP = NORMAL RECEPTACLE PANEL – 208/120V RP-N3-EB

0 ISSUE DATE 06/16/15

KEYPLAN

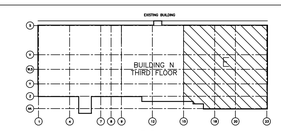

THIS RECORD DRAWING ISSUE (REVISION #2) HAS BEEN DRAFTED BY CE&IC BASED ON CONTRACTOR RED-LINED MARKUPS PROVIDED BY THE OWNER.

FLOOR PLAN SCALE: 3/16"=1'-0"
0 2' 4' 6' 8'

NO	REVISIONS	APPROVED	DATE
7	UPDATED PER CC 4835781	ND	3/28/25
6	ADC COMMERCIAL UPGRADES PROJ# 21-2068 CC#3345512	DG	9/9/22
5	AS BUILT DRAWING	DT	09/13/22
4	AS BUILT PROJECT #17-2060 ECM #500000005671	BB/RGF	05/21/18
3	AS BUILT UNDER ECM #500000002491	RWK/RGF	08/13/15
2	FOR RECORD ECM #500000002491	DEH	06/15/15
1	RE-ISSUE FOR BID – N3 ADC PROJECT	DEH	06/27/14
0	ISSUE FOR BID	DEH	06/11/14

CONSULTING ENGINEER
CE&IC
serving the pharmaceutical, biotech & chemical industries since 1989
two tant lane • suite 15 • bethlehem, new jersey • 08018
phone 610-317-1150 • fax 610-317-1227 • e-mail ce@ceandic.com
ENGINEERING DESIGN BETWEEN MODERN PROCESS UTILITIES CHEMICAL PLANT
CHEMICAL ENGINEERING & INSTRUMENTATION CONSULTANTS, INC.
ENGINEERING CERTIFICATE OF AUTHORITY NO. F01363794

SEAL

PROJECT LOCATION
SIGMA-ALDRICH
BUILDING N
3300 S. SECOND STREET
SAINT LOUIS, MO
63118
USA

SIGMA-ALDRICH
MANUFACTURING LLC

TITLE: N3 ADC FACILITY MODIFICATION PROJECT
ELECTRICAL PLAN
EAST BAY – THIRD FLOOR

PLANT: CHEROKEE BLDG: N FLOOR: 3RD

DRAWN: JMK SCALE: 3/16"=1'-0" DATE: 03/17/14
CHECKED: – APPROVED: DATE: –

10-055-E100

F:\BC-WORKSPACE\S1186888\M-USSLWI0002\D-SIGMARCH\MASTERS\CHEROKEE\N ELEC\10-055-E100.DWG