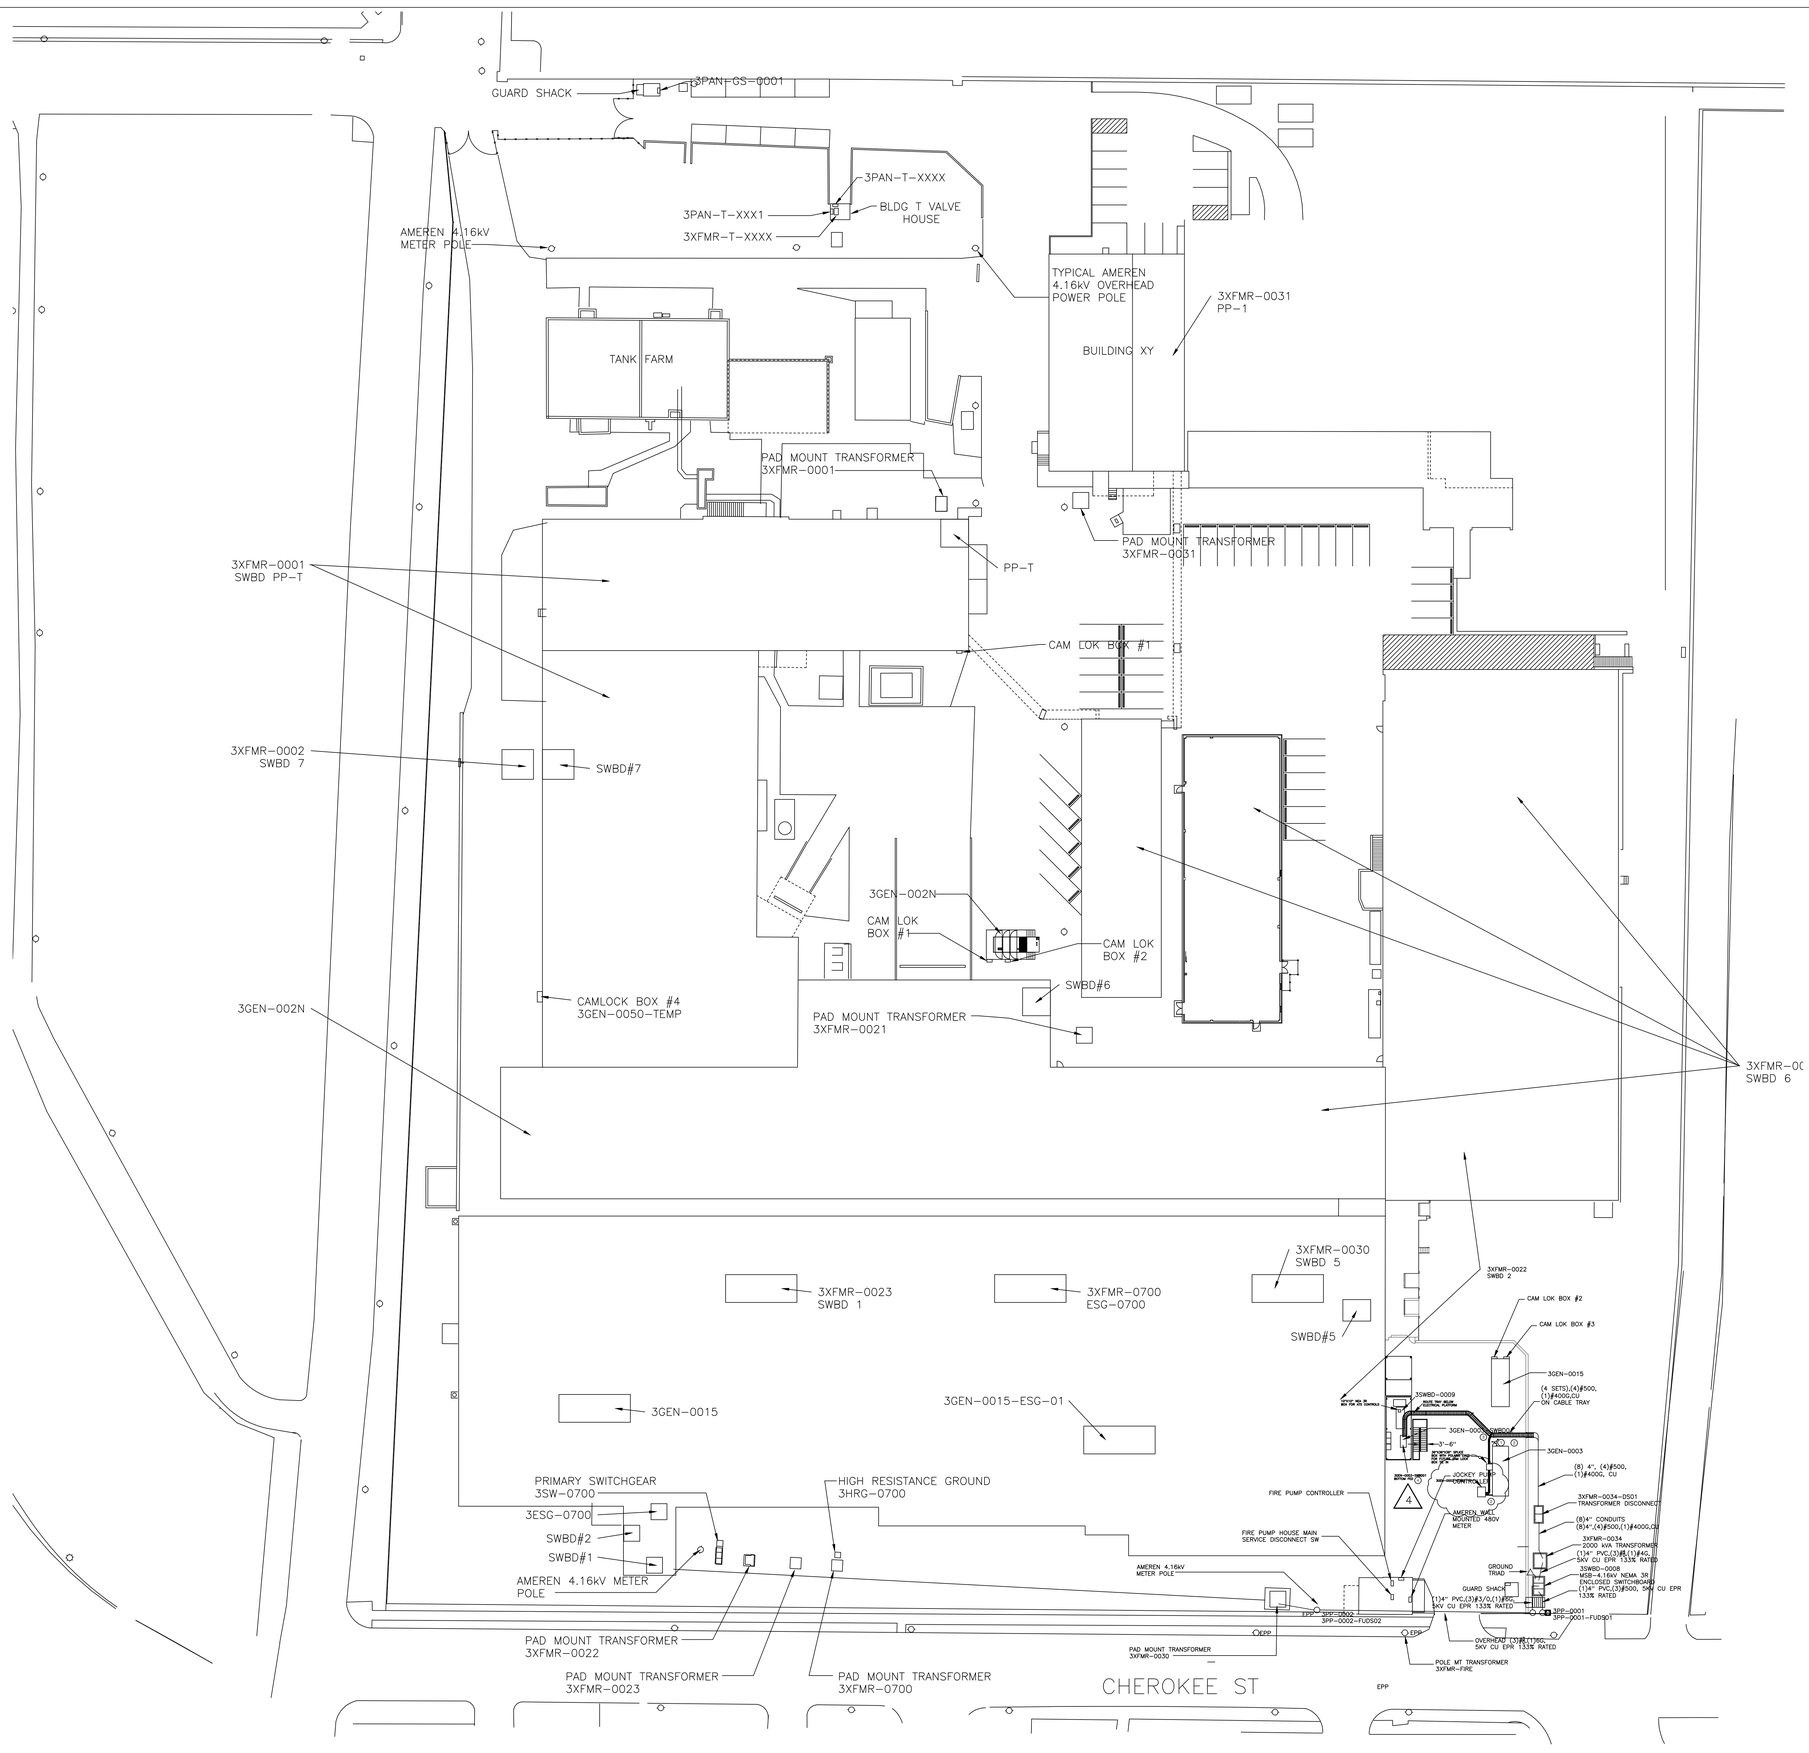


⑪ SHEET KEYNOTES:

1. PROVIDE GROUNDING ELECTRODE SYSTEM PER DETAIL 5 BELOW AND NEC 250 PART III. FINAL RESISTANCE TO EARTH SHALL BE LESS THAN 25 OHMS.

2. MECHANICAL MOUNTING CONNECTION BETWEEN CATWALK/PLATFORM AND GENERATOR SHALL SERVE AS GROUNDING BOND. CONFIRM CONTINUITY AFTER INSTALLATION AND PROVIDE SUPPLEMENTAL BONDING JUMPER WHERE REQUIRED.

3. COORDINATE SUPPLEMENTAL BONDING JUMPER REQUIREMENTS WITH CABLE TRAY MANUFACTURER'S INSTALLATION DOCUMENTS.

4. PROVIDE 90 DEGREE ELBOWS TO TRANSITION GENERATOR POWER AND DEDICATED EQUIPMENT GROUNDING CONDUCTORS FROM TRAY AND STUB INTO BOTTOM OF SWITCHBOARD. ELBOWS SHALL HAVE GROUNDING BUSHINGS AND BONDING JUMPERS BETWEEN TRAY, CONDUIT, AND SWITCHBOARD ENCLOSURE.

GENERAL NOTES:

1. THESE DRAWINGS ARE NOT TO BE CONSIDERED AS–BUILT OR AS–RECORDED. ANY MODIFICATIONS TO THE EXISTING ELECTRICAL SYSTEM MUST BE FIELD VERIFIED.
2. ALL CONDUIT SIZES SHOWN ARE ESTIMATED ONLY AND NOT FIELD VERIFIED.
3. ALL GROUND CONDUCTOR SIZES SHOWN ARE ESTIMATED ONLY AND NOT FIELD VERIFIED.
4. ALL MOTOR HORSEPOWER, STARTER SIZES, OVERLOADS, AND DRIVES ARE SHOWN ESTIMATED ONLY. FIELD VERIFY ALL EXACT CONDITIONS.

1 CHEROKEE PLANT ELECTRICAL SITE LOCATION PLAN

SCALE: 1'' = 30'–0''

BUILDING NORTH

TRUE NORTH

0 30 60 120

SCALE: 1'' = 30'–0''

NO	REVISIONS	APPROVED	DATE
4	GENERATOR DOCKING STATION AS-BUILTS	RU	06-16-26
3	UPDATED PER CC 4944226 & 4792677	BS	10-02-25
2	UPDATE VIA FIELD OBSERVATION	SN	11-15-22
1	CHEROKEE ELECTRICAL SITE LOCATION PLAN	CK	05-31-15

MilliporeSigma
A business of Merck KGaA, Darmstadt, Germany

TITLE: CHEROKEE PLANT
SITE ELECTRICAL LOCATION PLAN

SITE: CHEROKEE	BLDG: N/A	FLOOR: N/A

SCALE: 1"=30'-0" WHEN PLOTTED ANSI E	DRAWN: RCE	DATE: 04-30-15	DWG NO: 15-039-E001
	APPROVED: CK	DATE: 05-31-15	

Drawing File = F:\BC-WorkSpace\S118688\M-Ussl1w0002,D-SigmaArch\Masters\Cherokee\NA\Elec\15-039-E001.dwg
Plotted at 12:35pm on Jul 30, 2026 by S118688